


Do not scale from drawings. All discrepancies to be reported to the Architect immediately. All dimensions to be verified by the Contractor on site prior to any works, manufacture, or ordering of materials.  
Any small changes made on site may not be reflected on record drawings. Please refer to the Contractor's as-built fabrication drawings.

Key	
	Denotes: Existing wall
	Denotes: Works Area
	Denotes: Existing wall
	Denotes: Proposed wall construction
	Denotes: Existing trunking
	Denotes: New trunking
	Denotes: Existing Double socket.
	Denotes: Existing Double data.
	Denotes: Proposed Double socket.
	Denotes: Proposed Double data.

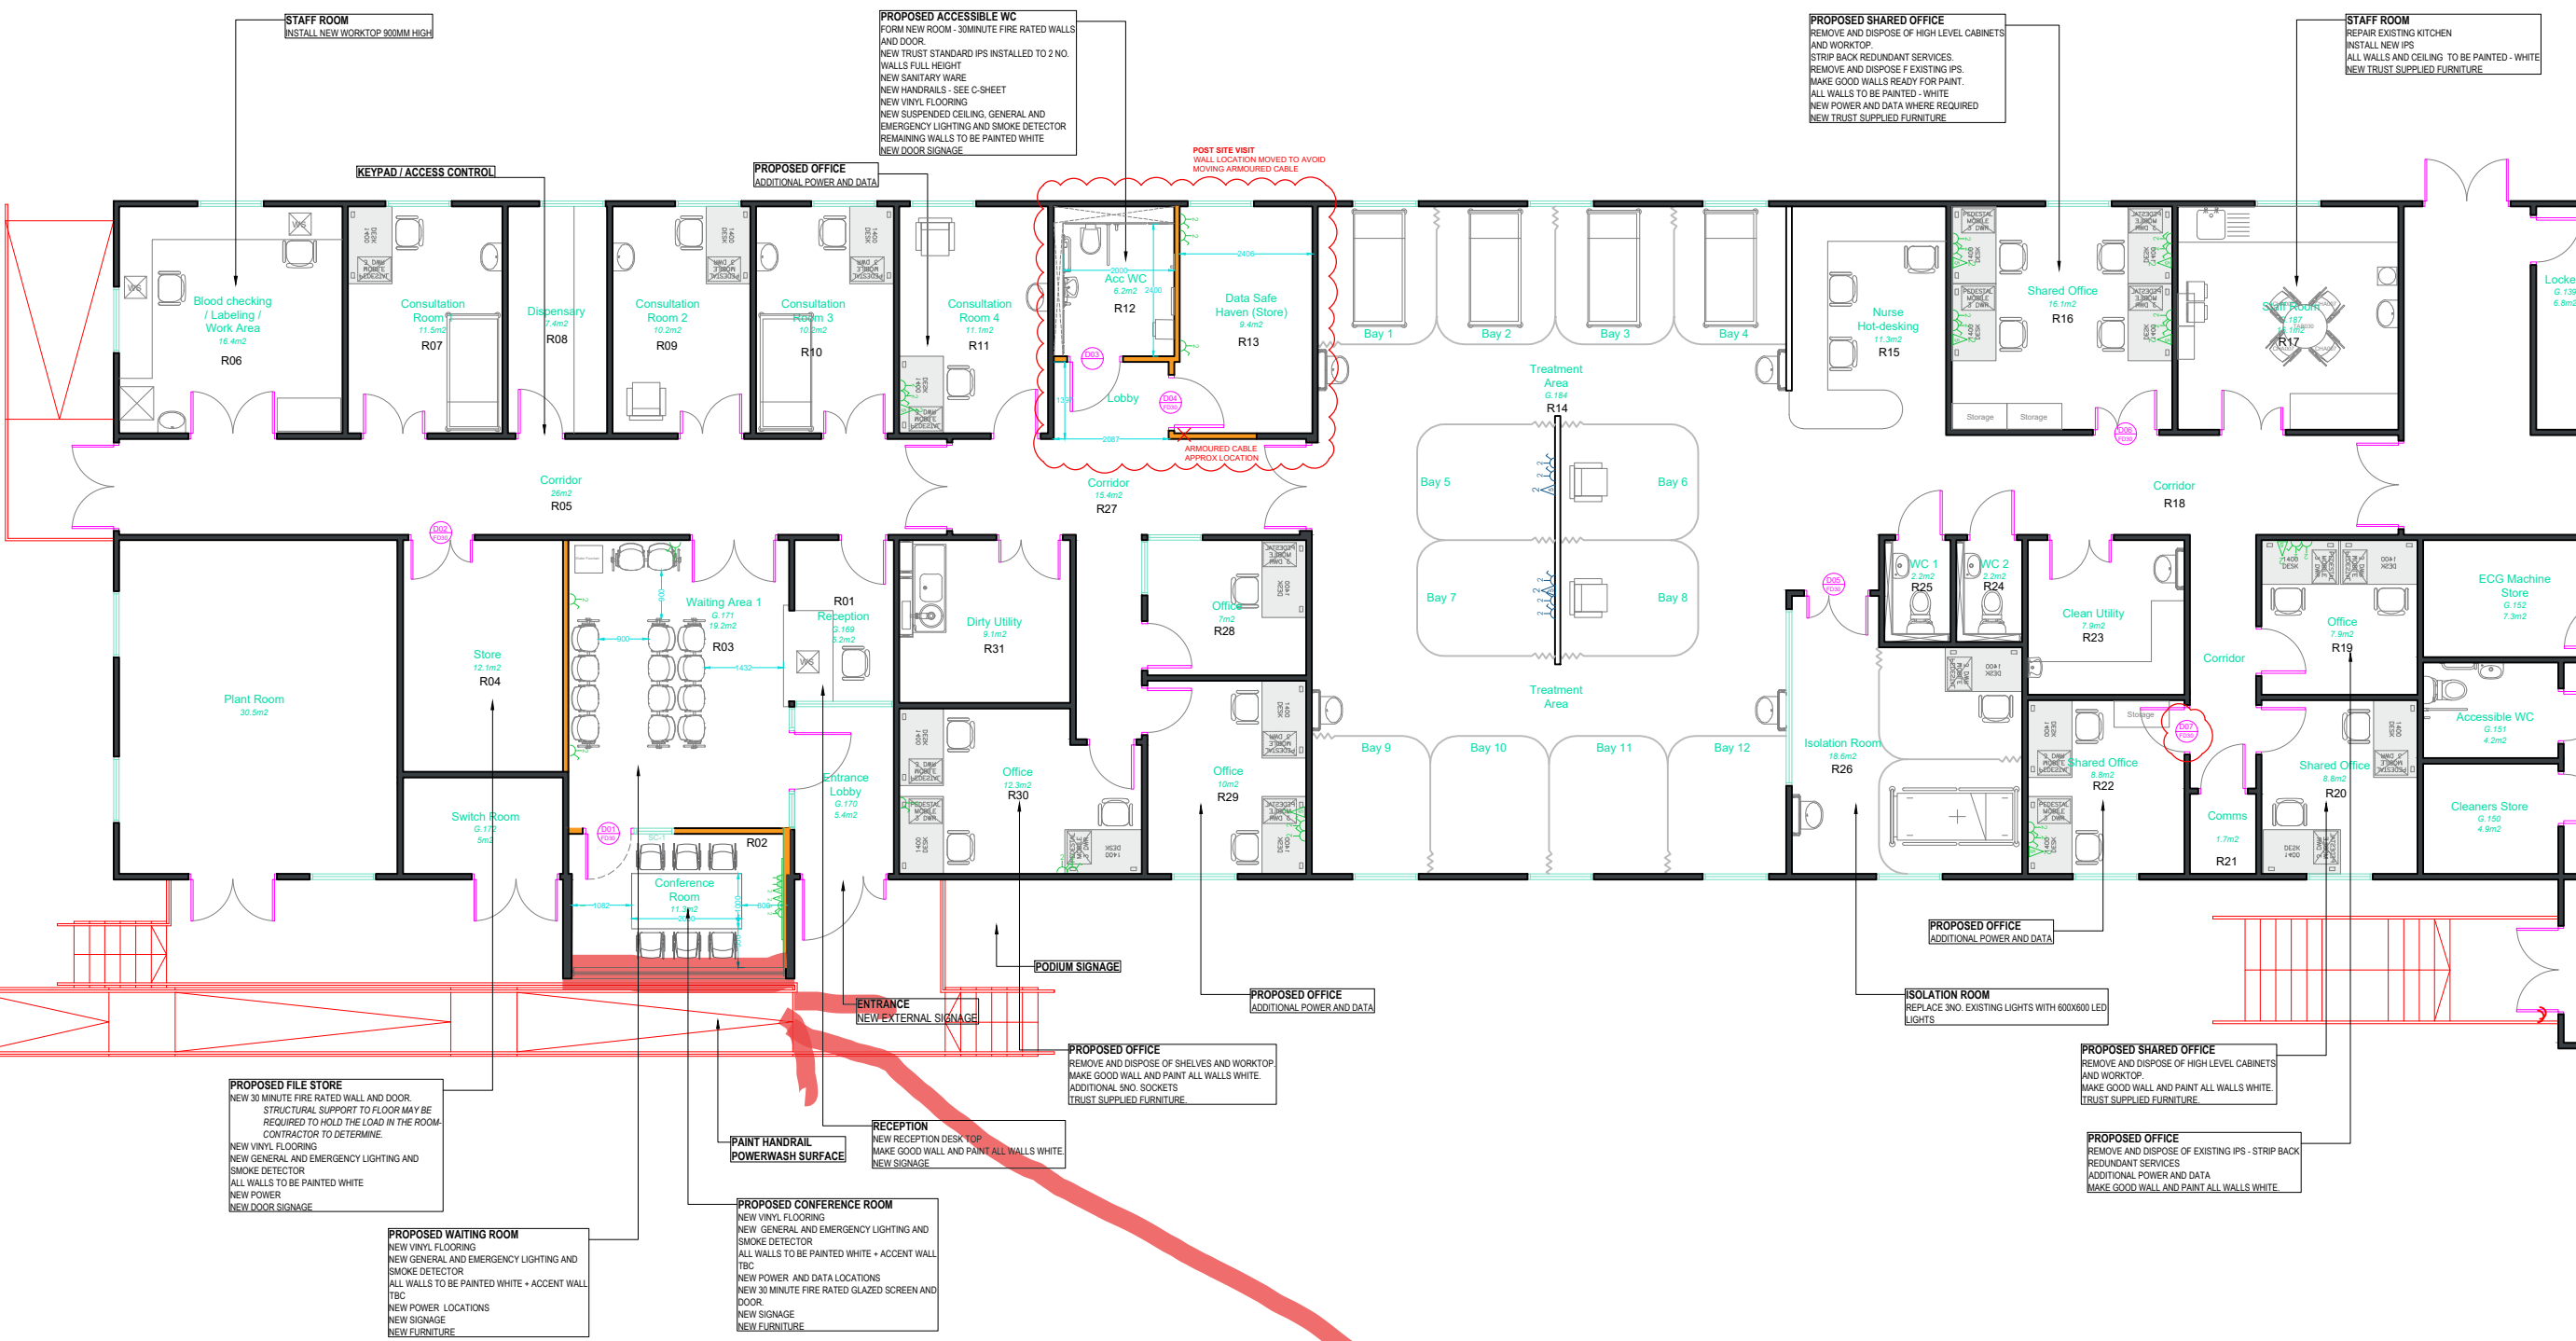

REV	DATE	DETAILS OF ISSUE	INITIALS
G	24/03/25	Worktop updated in Phlebotomy/Lab Room.	FG
F	14/03/25		FG
E	29/01/25	SEE Revision Clouds - on site changes	CR
D	29/01/25	SEE Revision Clouds - on site changes	CR
C	15/01/25	SEE Revision Clouds - additions to scope	CR
B	08/11/2024	Reduction in power, conference room changes and door changes	CR
A	14/02/24	Conference Room included	CR

**HSC** South Eastern Health and Social Care Trust

Insert Consultant's Logo & Contact Details Here

Project: **Research and Development Team Relocation**

Title: **Proposed**

Scale: NTS	Drawing No: 0002	Revision: G
Date Drawn: 13/12/2023	Drawn By: Courtney Rice	
Date Approved: dd/mm/yyyy	Approved By: full name	

Estates Services Department - Projects Team  
Home 7, Ulster Hospital, Dundonald, BT16 1RH  
Telephone: 028 9041 3600