

# Order For Awning

Supplier	Weinor
Order No.	SO9332
Customer Ref.	Carlyon House, St Brelade
Contact Tel.	01534 768141
Date of Order	09-12-2019
Date Required	09-12-2019

Invoice Details	
Name	Turnkey Project Management Ltd
Address	Burrard House Burrard Street St Helier
Postcode	JE2 4WS
Phone	858499

Delivery Details	
Name	Turnkey Project Management Ltd
Address	Burrard House, Burrard Street St Helier
Postcode	JE2 4WS
Phone	858499

System Type	Qty	Width mm	Drop mm	Fitting Height	Fabric	Frame Colour	Brackets	Controls	Fabric Type	Surface Fixing	Location
Further Instructions : Weinor Type N2000 recess fitted awning with frame 7037 and fabric 3-718, vibration sensor and remote control operation	1	9000 9100	3500								
	1	<del>8500</del> 8700	3500								
Further Instructions : Weinor Type 12000 awning with LED Design light bar, frame 7037 and fabric 3-718, vibration sensor and remote control operation	1	<del>8600</del> 8950	2500								
Further Instructions : Weinor Type 12000 awning with LED Design light bar, frame 7037 and fabric 3-718, vibration sensor and remote control operation	1	0	0								
Further Instructions : Weinor BiEasy set to allow operation via App											

12000 x 2 one remote  
N2000 x 1





April 29, 2020

REF : SO9332

Turnkey Project Management Ltd  
Burrard House  
Burrard Street  
St Helier  
JE2 4WS

CUS. REF : Carlyon House, St Brelade

Dear Julian Smith

As requested, we have pleasure in submitting our quotation for the following.

Description	QTY	Price
To Supply and Fit ,Awning, Electric operation - Right hand, Weinoor Type N2000 recess fitted awning with frame 7037 and fabric 3-718, vibration sensor and remote control operation,	1	£ 8,239.00
To Supply and Fit ,Awning, Electric operation - Left hand, Weinoor Type I2000 awning with LED Design light bar, frame 7037 and fabric 3-718, vibration sensor and remote control operation,	1	£ 8,304.00
To Supply and Fit ,Awning, Electric operation - Right hand, Weinoor Type I2000 awning with LED Design light bar, frame 7037 and fabric 3-718, vibration sensor and remote control operation,	1	£ 3,960.00
To Supply and Fit ,Awning, Weinoor BiEasy set to allow operation via App.,	1	£ 860.00
<b>Subtotal :</b>		<b>£ 21,363.00</b>
<b>GST :</b>		<b>£ 1,068.15</b>
<b>Total :</b>		<b>£ 22,431.15</b>

As with all our custom orders, we will require a deposit of 50%. All prices are subject to GST. Wiring not included.

We are pleased to advise that our Awnings are covered with a 5-year guarantee.

Thank you for your enquiry and we hope you will find this quotation acceptable. Should you require any further information, please contact us.

Yours sincerely

Adrian Colston-Weeks

DIRECTOR

To accept the above quotation, please indicate which option is required, sign below and return this letter together with your deposit. Please note extract of our terms and conditions below.

.....  
SIGNATURE DATE

Please note: This quotation is only valid for acceptance for 60 days. Our estimate does not include any electrical work or additional carpentry work to install the above unless otherwise specified. Please note there is a handling charge on customer own fabric of £5 per metre. Due to high costs of labour, pre-arranged missed fitting appointments will be charged on a time-wasted basis. Settlement is due on completion of works and an administration charge of £25 will be added per month if unpaid within 30 days. We reserve the right to charge for design, advice and liaison work carried out should an order not be placed. Goods remain the property of CP Interiors until full settlement is received. Should payment not be received we reserve the right to attend premises during working hours to remove goods and not be required to make good. Our full terms and conditions apply and are available on request.

- Call us and pay by Card, we accept card transactions over the telephone and we will not charge you a handling fee.
- Bank details: Natwest, Sort Code 60-12-03, Account No 66577772

If you pay your deposit by BACS payment, please confirm the details of your order by returning a signed copy of this letter

Tel (01534) 768141


[www.cpinteriors.ie](http://www.cpinteriors.ie)

Rue des Pres Trading Estate, St Saviour, Jersey, JE2 7QN

Blinds | Curtains | Awnings | Shutters | Furnishings | Interior Design | Project Management


Bracket and arm position N2000  
joint unit

900 x 350 cm 4 arms

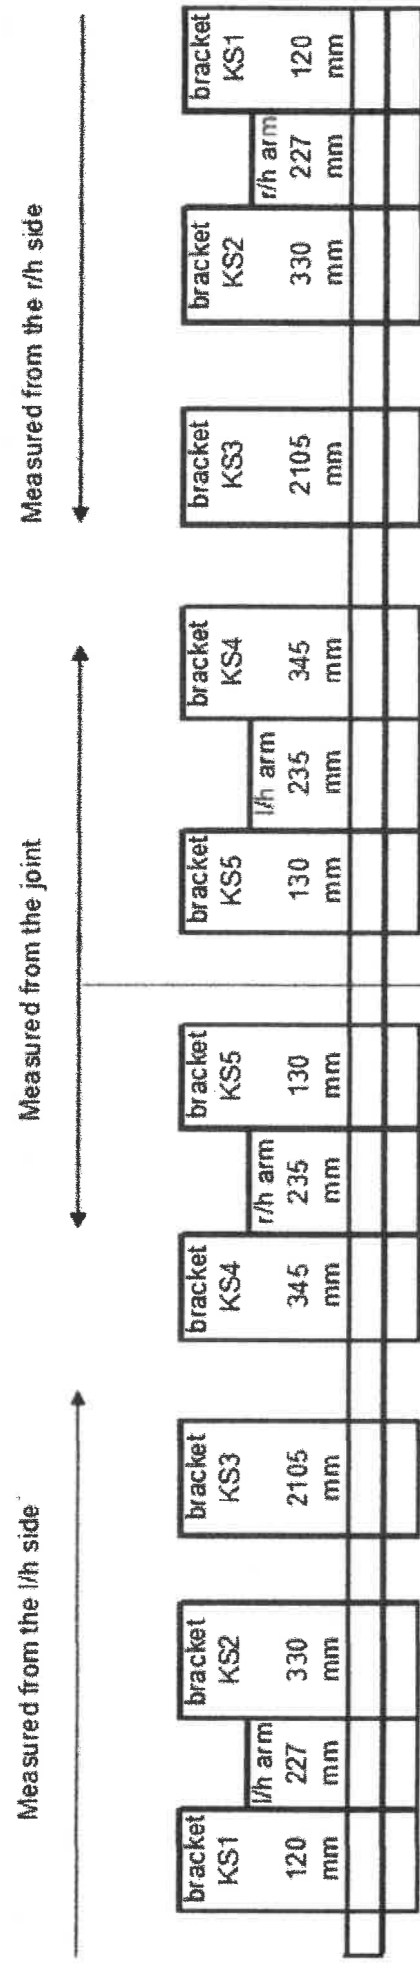

Mit freundlichen Grüßen / Yours sincerely  
Jürgen Büchel  
CustomerCenter |

9.000 x 3500  
Brackets  
position  
Email Georgie

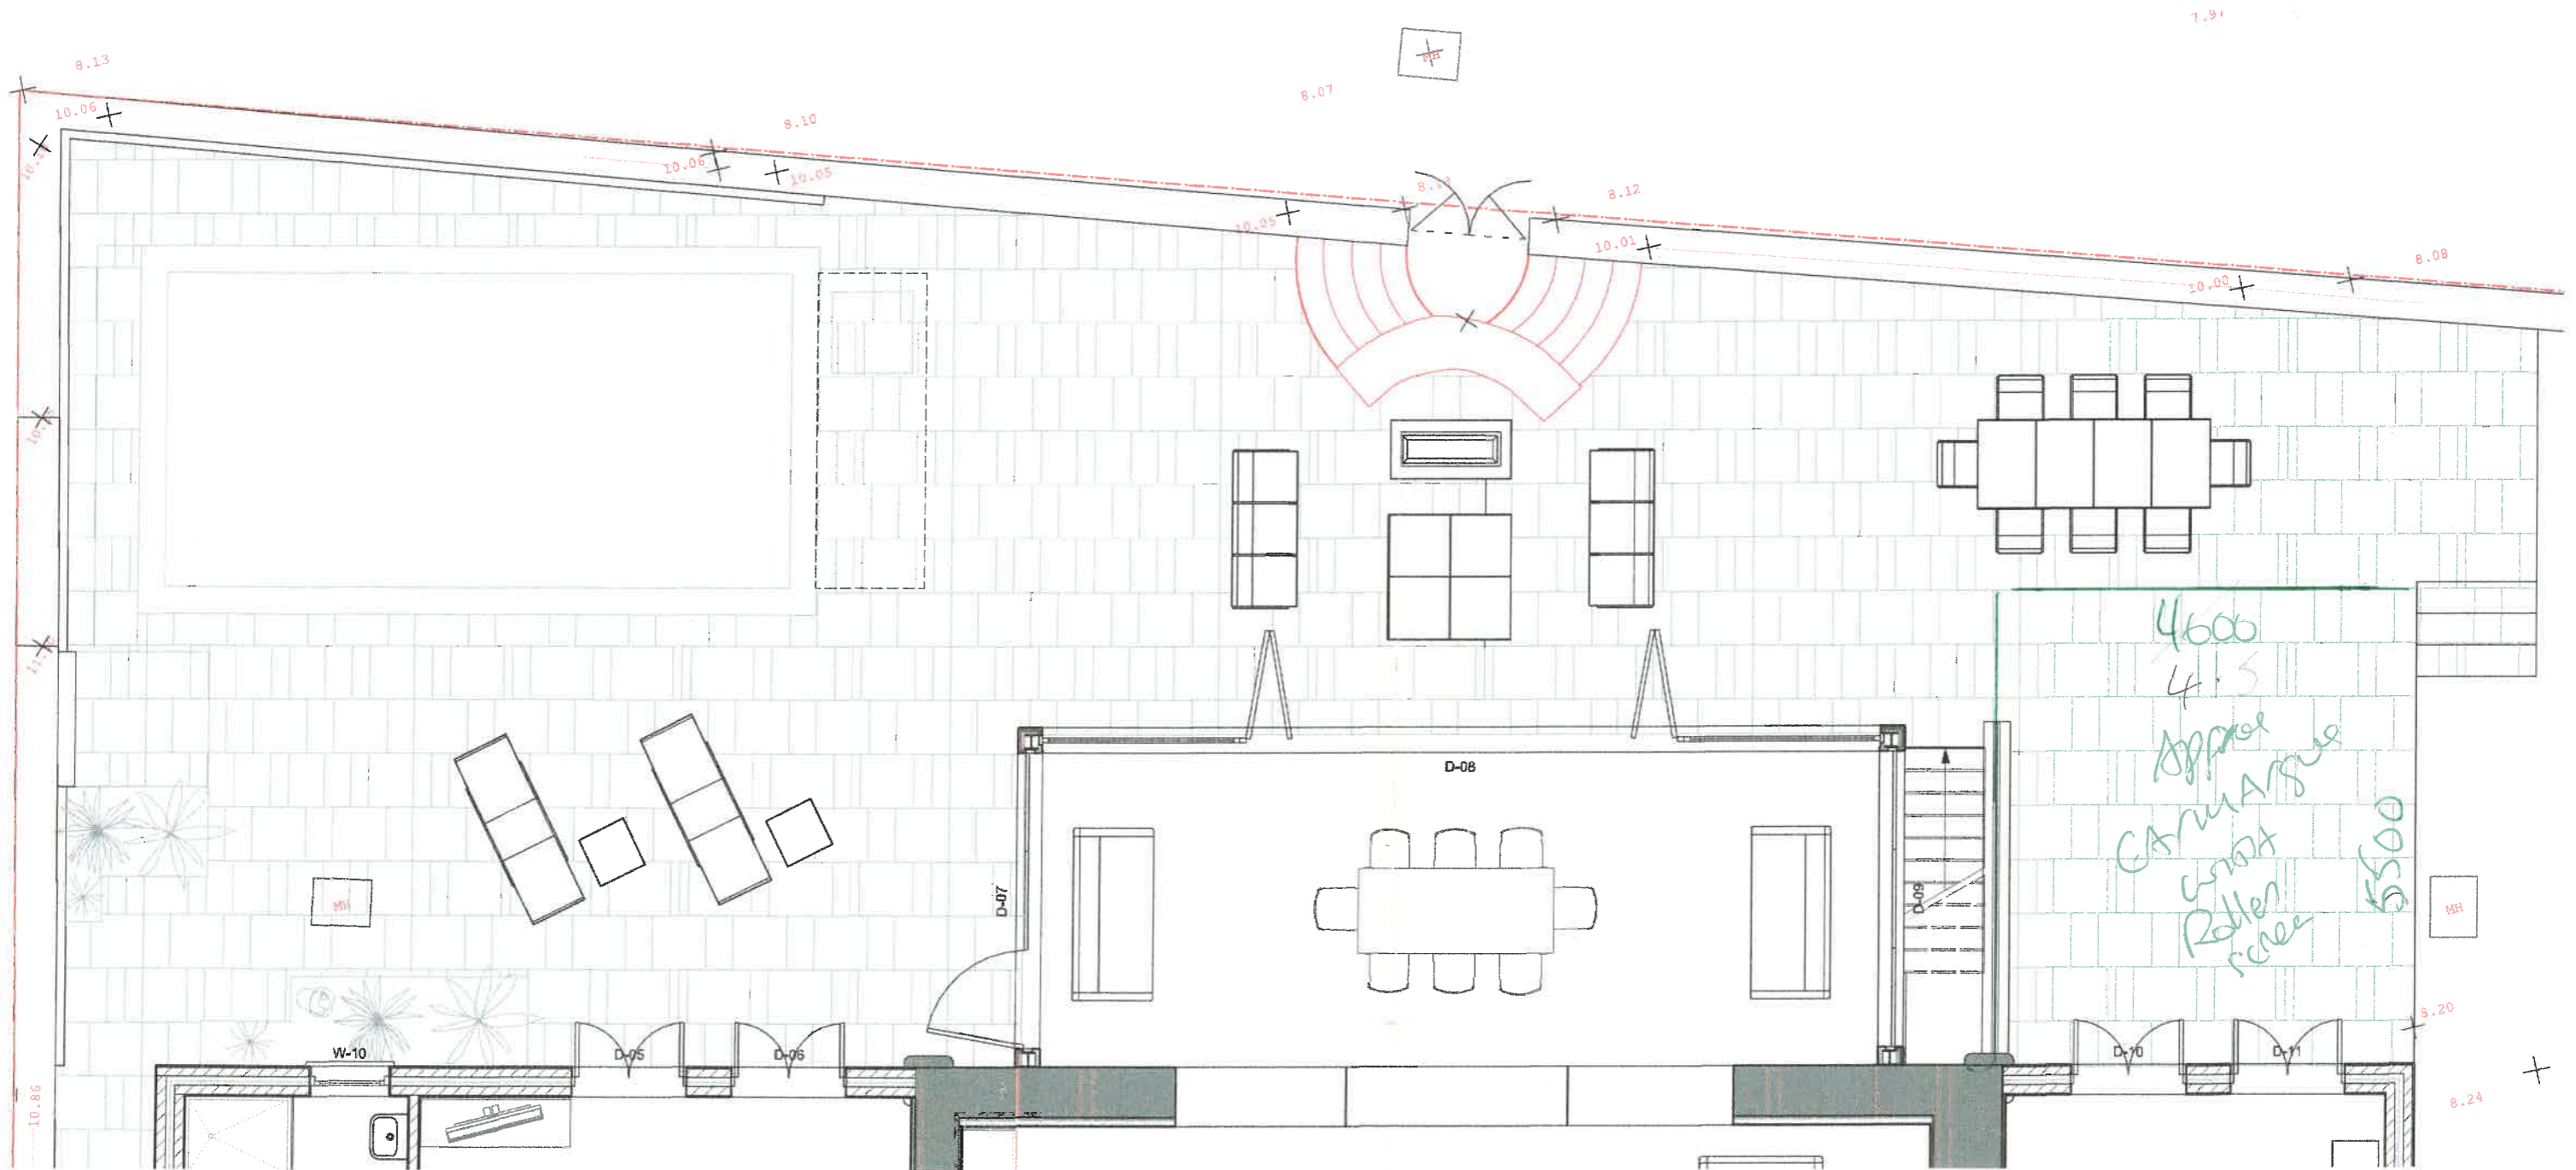

<b>Richard Le Sueur Architects</b> <small>M.A. Dip. Arch, Cantab; R.I.B.A.</small> <small>tel: 01334 626874 e-mail: rlsrch@gmail.com</small> <small>5 Mfinden Place, St Helier, Jersey JE2 4WQ</small>	<b>job</b> Carlyn House La Route de la Baie, St Brelade	<b>scale @ A2</b> 1:50	<b>job no.</b> 16/14
	<b>dwg</b> Bye-law - Terrace plan	<b>date</b> Mar 2018	<b>dwg. no.</b> 16/14/T1