

4x Boxes Clapham x 2
Whitsey x 2

COMMERCIAL INVOICE

Ship to: Company name	CP Interiors	Importers Ref:	
Street	Rue des Pres Trading Estate St Saviour	Reason for Export	GOODS FOR SALE
Town	St Saviour		
State/Country	JERSEY	Postcode	JE2 7QN
Contact name	Mr Adrian Colston Weeks		
Tel/Fax/No:	01534768141	Goods are of	UK Origin

Full Description of goods <small>(What is it? What is it made from? Usage of goods)</small>	Commodity Codes	Items Value	Total Value	Currency
INSHADE CONSERVATORY SAILS (STRETCH FABRIC SAILS + STAINLESS STEEL FITTINGS)	63031200 73259990			£2,215.52
No of Packages: 2 Dimensions: 400x330x330 Total Weight: 10.01				
Shippers VAT No.	804 2124 78		Total	£2,215.52

RECEIVED
21 JUL 2022

SO11842 - CLAPHAM - 2 BOXES
SO13289 - WHITSEY - 2 BOXES

Name and address of Manufacturer: tensARC Ltd
UNIT 27, STIRLING ENTERPRISE PARK, STIRLING FK7 7RP

I declare that the above information is true and correct to the best of my knowledge

Name: Kerry Thomson Signature: *Kerry Thomson*
Title: Production Manager Date: 19/07/2022

WHITSEY 8013289



Custom Sail Survey - Option 01

Required Dims :

Sail 01	Sail 02	Sail 03	Sail 04	Sail 05	Sail 06
AB 114.5	GH 114.5	NP 2310	NX 2310	GT 114.5	AY 114.5
BC 114.5	HJ 115.5	PQ 1090	XW 1090	T-A1 1155	Y-D1 114.5
CD 64.5	JK 131.5	QR 169.5	VV 169.5	A1-Z 131.5	D1-C1 64.5
DE 114.5	KB 1150	RS 138.5	VU 138.5	ZY 1150	C1-B1 114.5
EF 144.5	BL 114.5	SH 114.5	UT 114.5	YL 114.5	B1-F 144.5
FA 64.5	LG 1360	HM 114.5	TM 114.5	LG 1360	FA 64.5
BF 135.5	BG 1810	MN 540	MN 340	YG 1810	YF 135.5
BE 75.5	BH 146.5	NQ 2420	NW 2420	YT 146.5	Y-B1 75.5
BD 133.5	BJ 1810	NR 2420	NV 2470	Y-A1 1810	Y-C1 133.5
EA 1330	HL 1810	NS 2340	NU 2360	TL 1810	B1-A 1330
EC 1330	HK 1800	NH 1295	NT 174.5	TZ 1800	B1-D1 1330
		HR 1840	TV 1840		
		RP 2595	VX 2595		
		RM 2655	VM 2655		
		QS 2860	WU 2860		
		SP 3495	UX 3495		

Opener Dims :
 L-Z1 ~~905~~ 905
 G-Z1 910
 B-Z1 ~~920~~ 920
 H-Z1 940

L-Y1 ~~910~~ 910
 G-Y1 900
 T-Y1 940
 Y-Y1 940

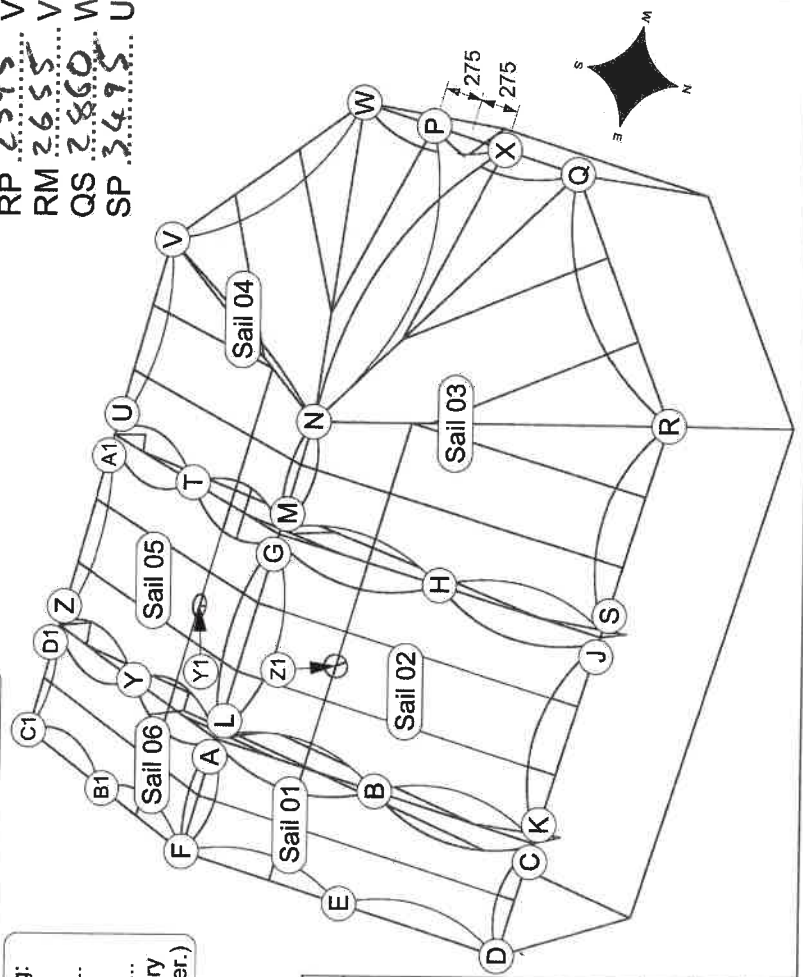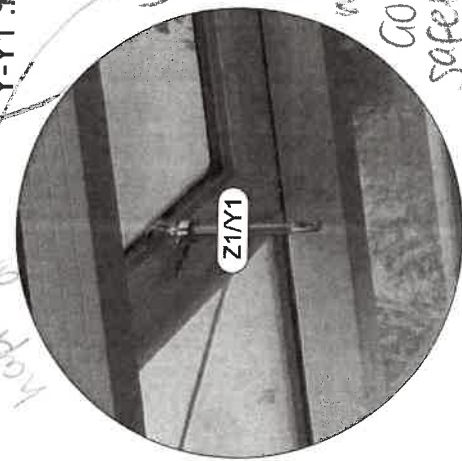

SURVEY CHECKLIST: ***to be completed on site***

- All top fittings to be on the ridge, with A/L/G/M 40mm away from brackets allow room for fitting.
- Lower points C/K/J/S/X/P/U/A1/Z/D1 should be fixed to the bottom of the vertical fascia and 40mm away from brackets to allow room for fitting
- Lower points D/R/Q/W/N/C1 should be fixed to the bottom of the underside roof glazing bars, 30mm up from the point where the glazing bar meets the fascia.
- Intermediate points E/B/H/T/Y/B1 to be at midpoints of their respective sail edges on the underside of roof glazing bars.
- Point Z1/Y1 to be taken from the vent opener screw with the window in the closed position as per inset photo.
- Points X/P to be set at 275mm away from the front central glazing panel midpoint or in-line with glazing bars if difference is less than 30mm.

Confirmation required for the following:

- Colour of Fabric
- Colour of Fittings

(Please note white & gold fittings carry a surcharge of £2+VAT per sail corner.)

Notes:	
Survey points to be taken from point on conservatory where eye plates are to be fixed.	
MARK ALL POINTS BEFORE COMMENCING SURVEY	
Dimensions should be taken as accurately as possible ideally +/-5mm	
Design Shows: 6 x Made to Measure InShade Sails - ISX - TBC (Sails are shown in Ivory for design clarity)	
Obstructions: Tie-bars	
Special Fittings: None	
t : 01786 450083	e : inshade@shadeplus.co.uk
Project: 72292-9358-Whitsey	
Date: 22/06/22	Drawn: LW
	Check: AB