


PROPOSED GROUND FLOOR PLAN

0 1m 5m 10m
1:200



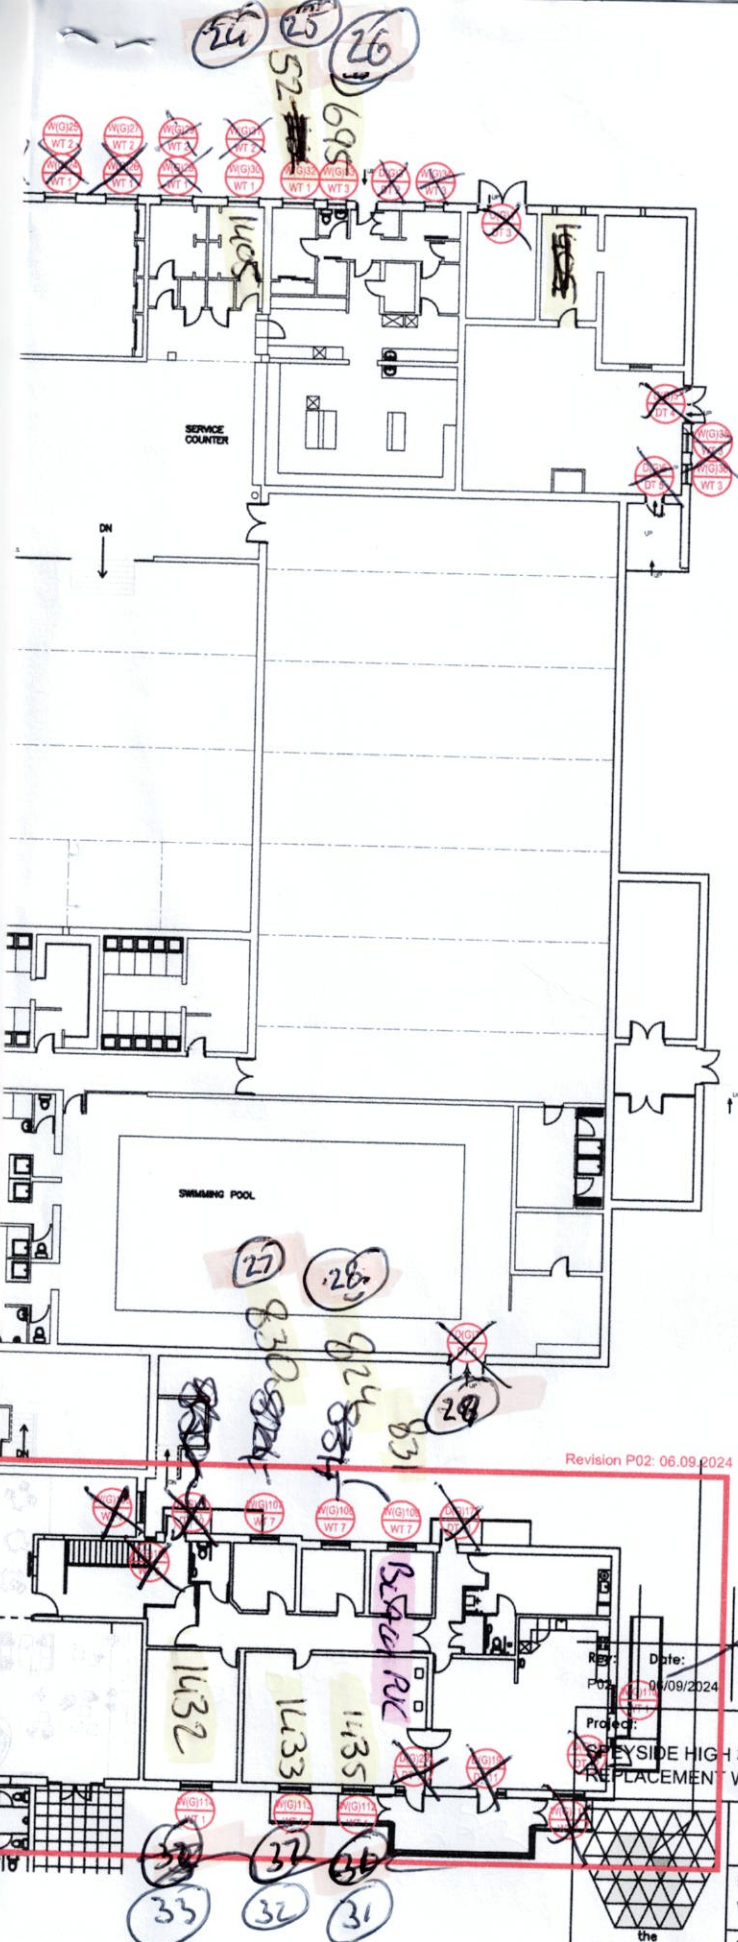

Unless
 All unless
 Low beams
 WAP Beam B/B
 PU 280 unless
 1430 drop unless

~~BEFORE STANDING~~
~~ON WORK TOPS CHECK~~
~~CARRY WEIGHT~~

50

Revision P02: 06.08.2024

30
 1430 x 1430

Ref: [redacted] Date: 04/09/2024 Project: SPEYSIDE HIGH SCHOOL WINDOWS AND DOORS REPLACEMENT	Drawn: WRMcK Description: SEN Windows and Doors added	Drawing Title: PROPOSED GROUND FLOOR PLAN
Scale: 1:200 Date: 23/04/2024 Drawn: WRMcK Checked: CK Purpose of Issue: TENDER	ENVIRONMENTAL SERVICES Design Manager The Moray Council Council Office High Street, Elgin, IV30 1BX Telephone: 01343 563701 Fax: 01343 563978	
Project Number: 619345 Originator: TMC Volume: XX Level: 00 Type: DR Role: A Number: 105 Rev: P02		